



Copyright material DO NOT PRINT

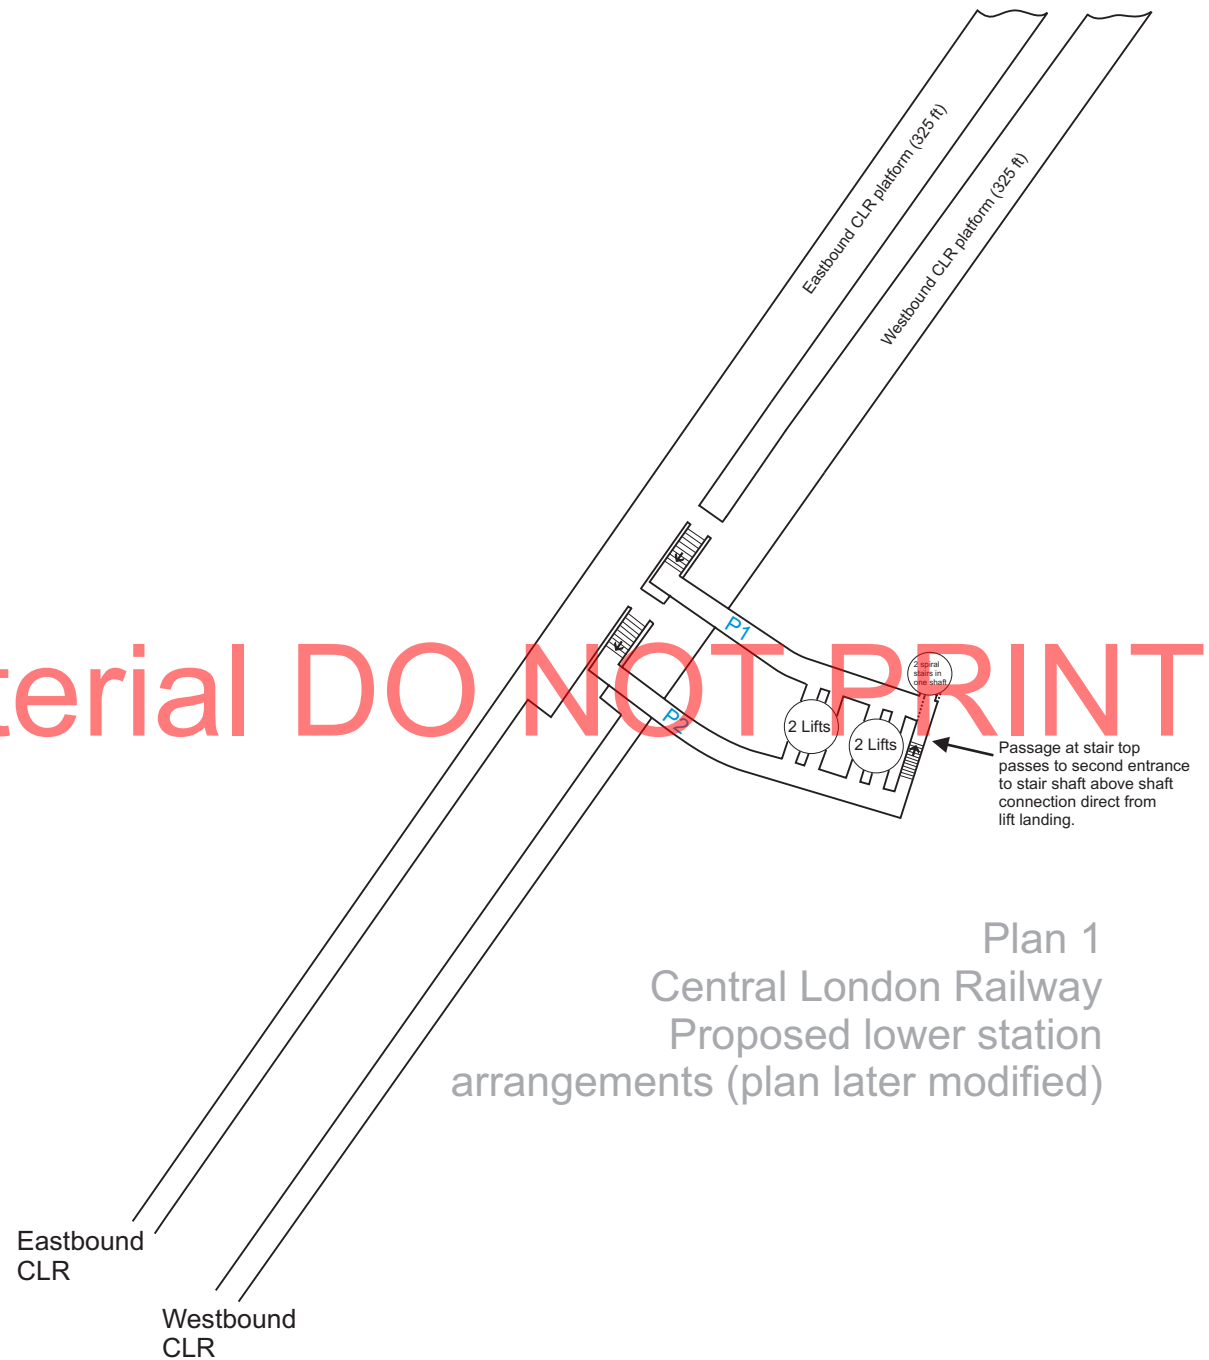

Plan 1
Central London Railway
Proposed lower station
arrangements (plan later modified)


Plan 2
Central London Railway
Proposed lower station
arrangements
(as built)

Copyright material DO NOT PRINT

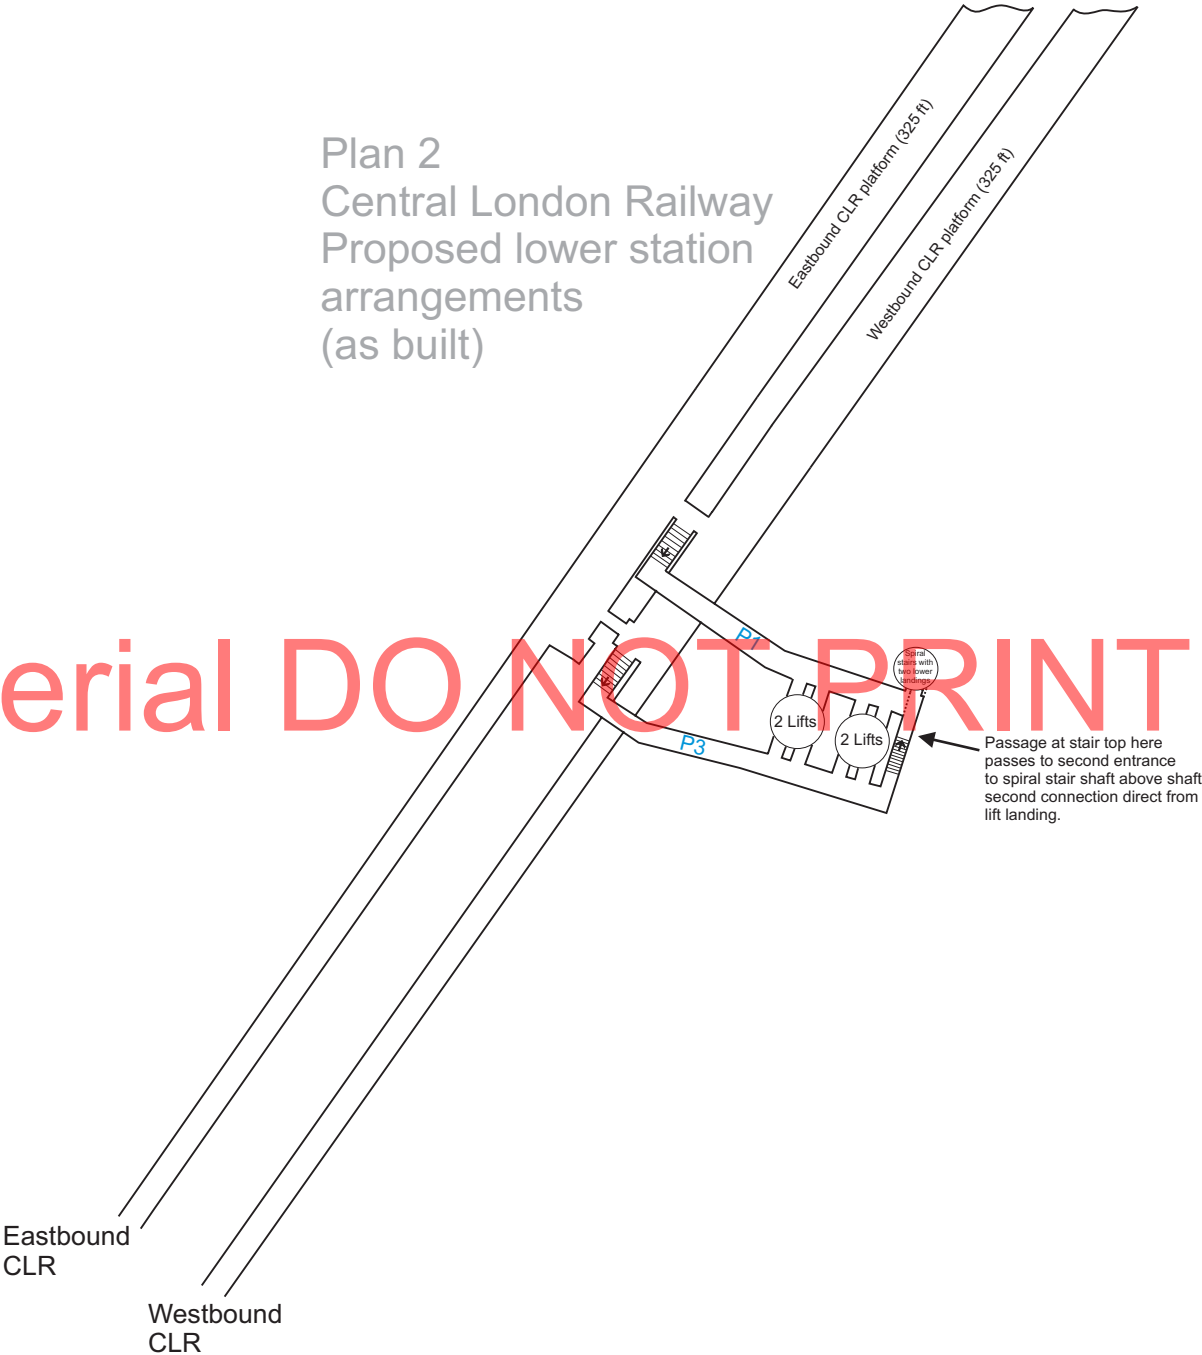


Copyright material **DO NOT PRINT**

Plan 3
Baker Street & Waterloo
Railway proposed lower
station arrangements
(original plan part built)

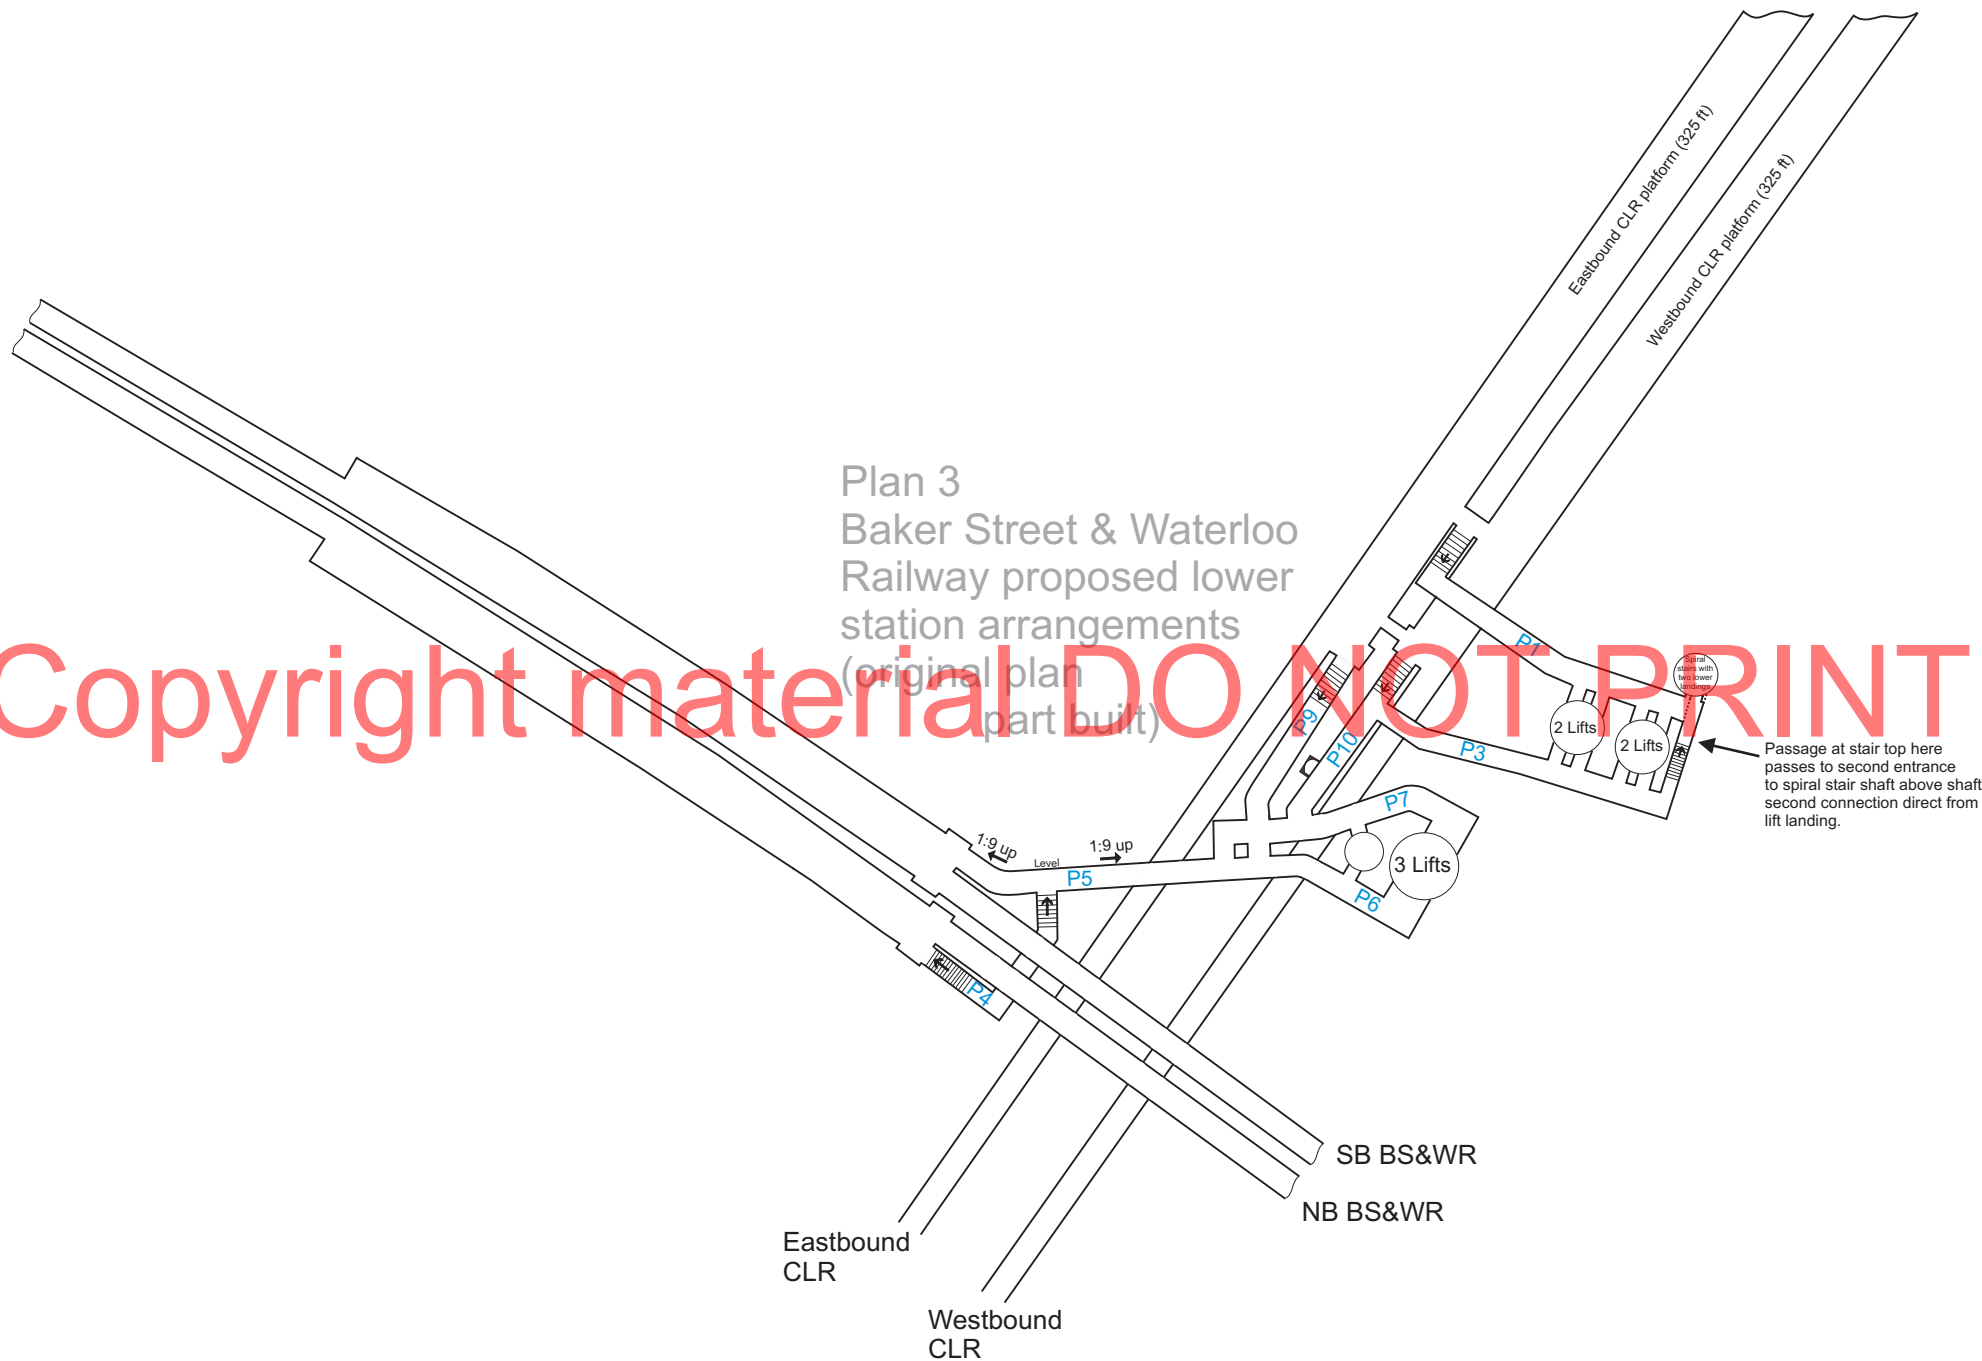


Copyright material DO NOT PRINT

Plan 4
Baker Street & Waterloo
Railway proposed lower
station arrangements
(second plan
part built)

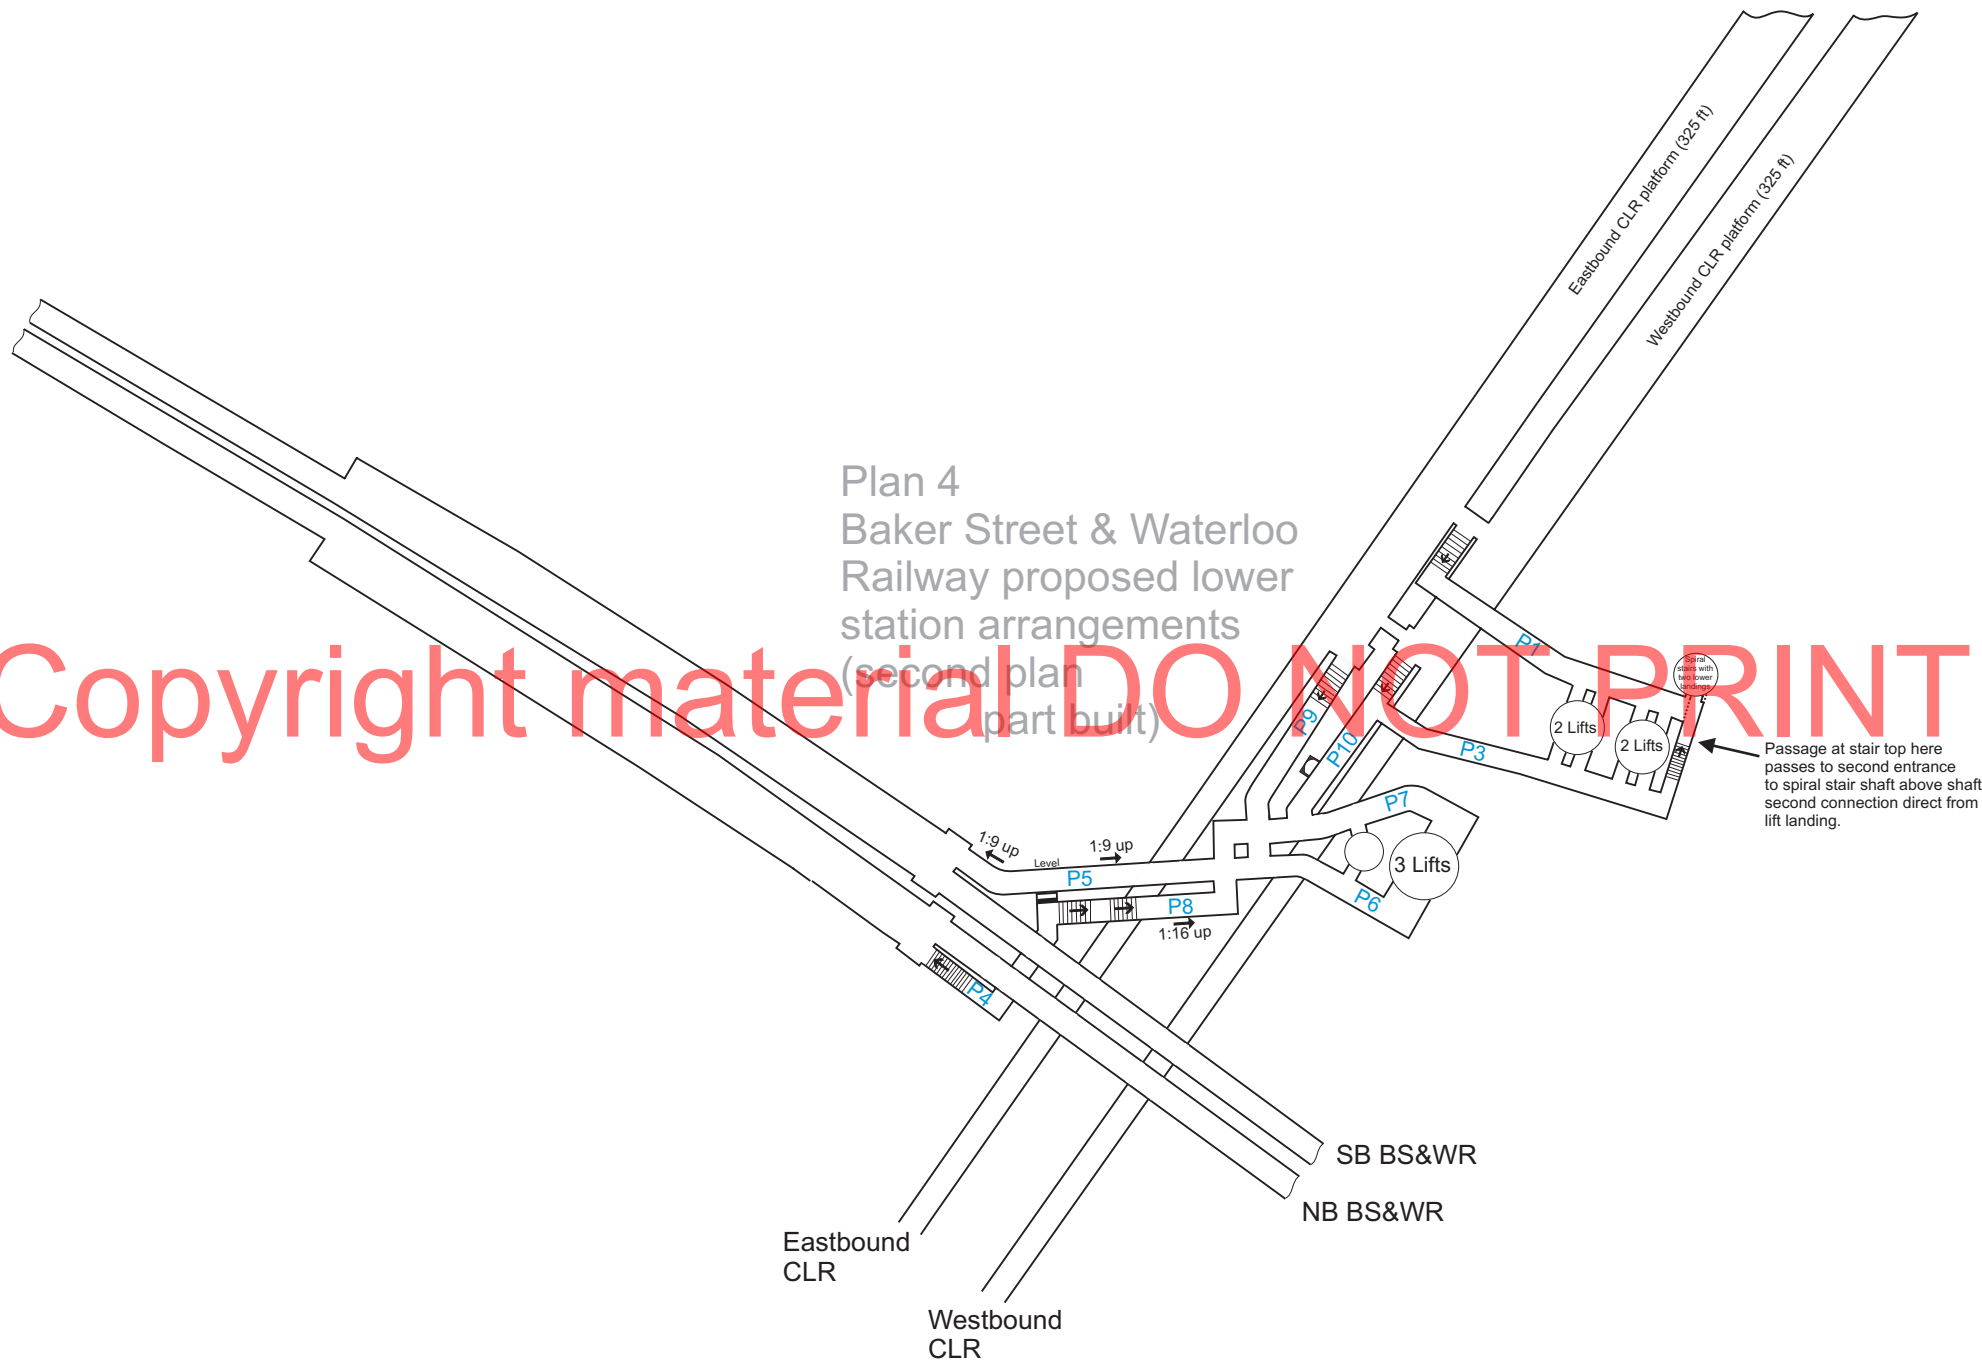


Copyright material DO NOT PRINT

Plan 5
Baker Street & Waterloo
Railway lower
station arrangements
with CLR connexions
(as built)

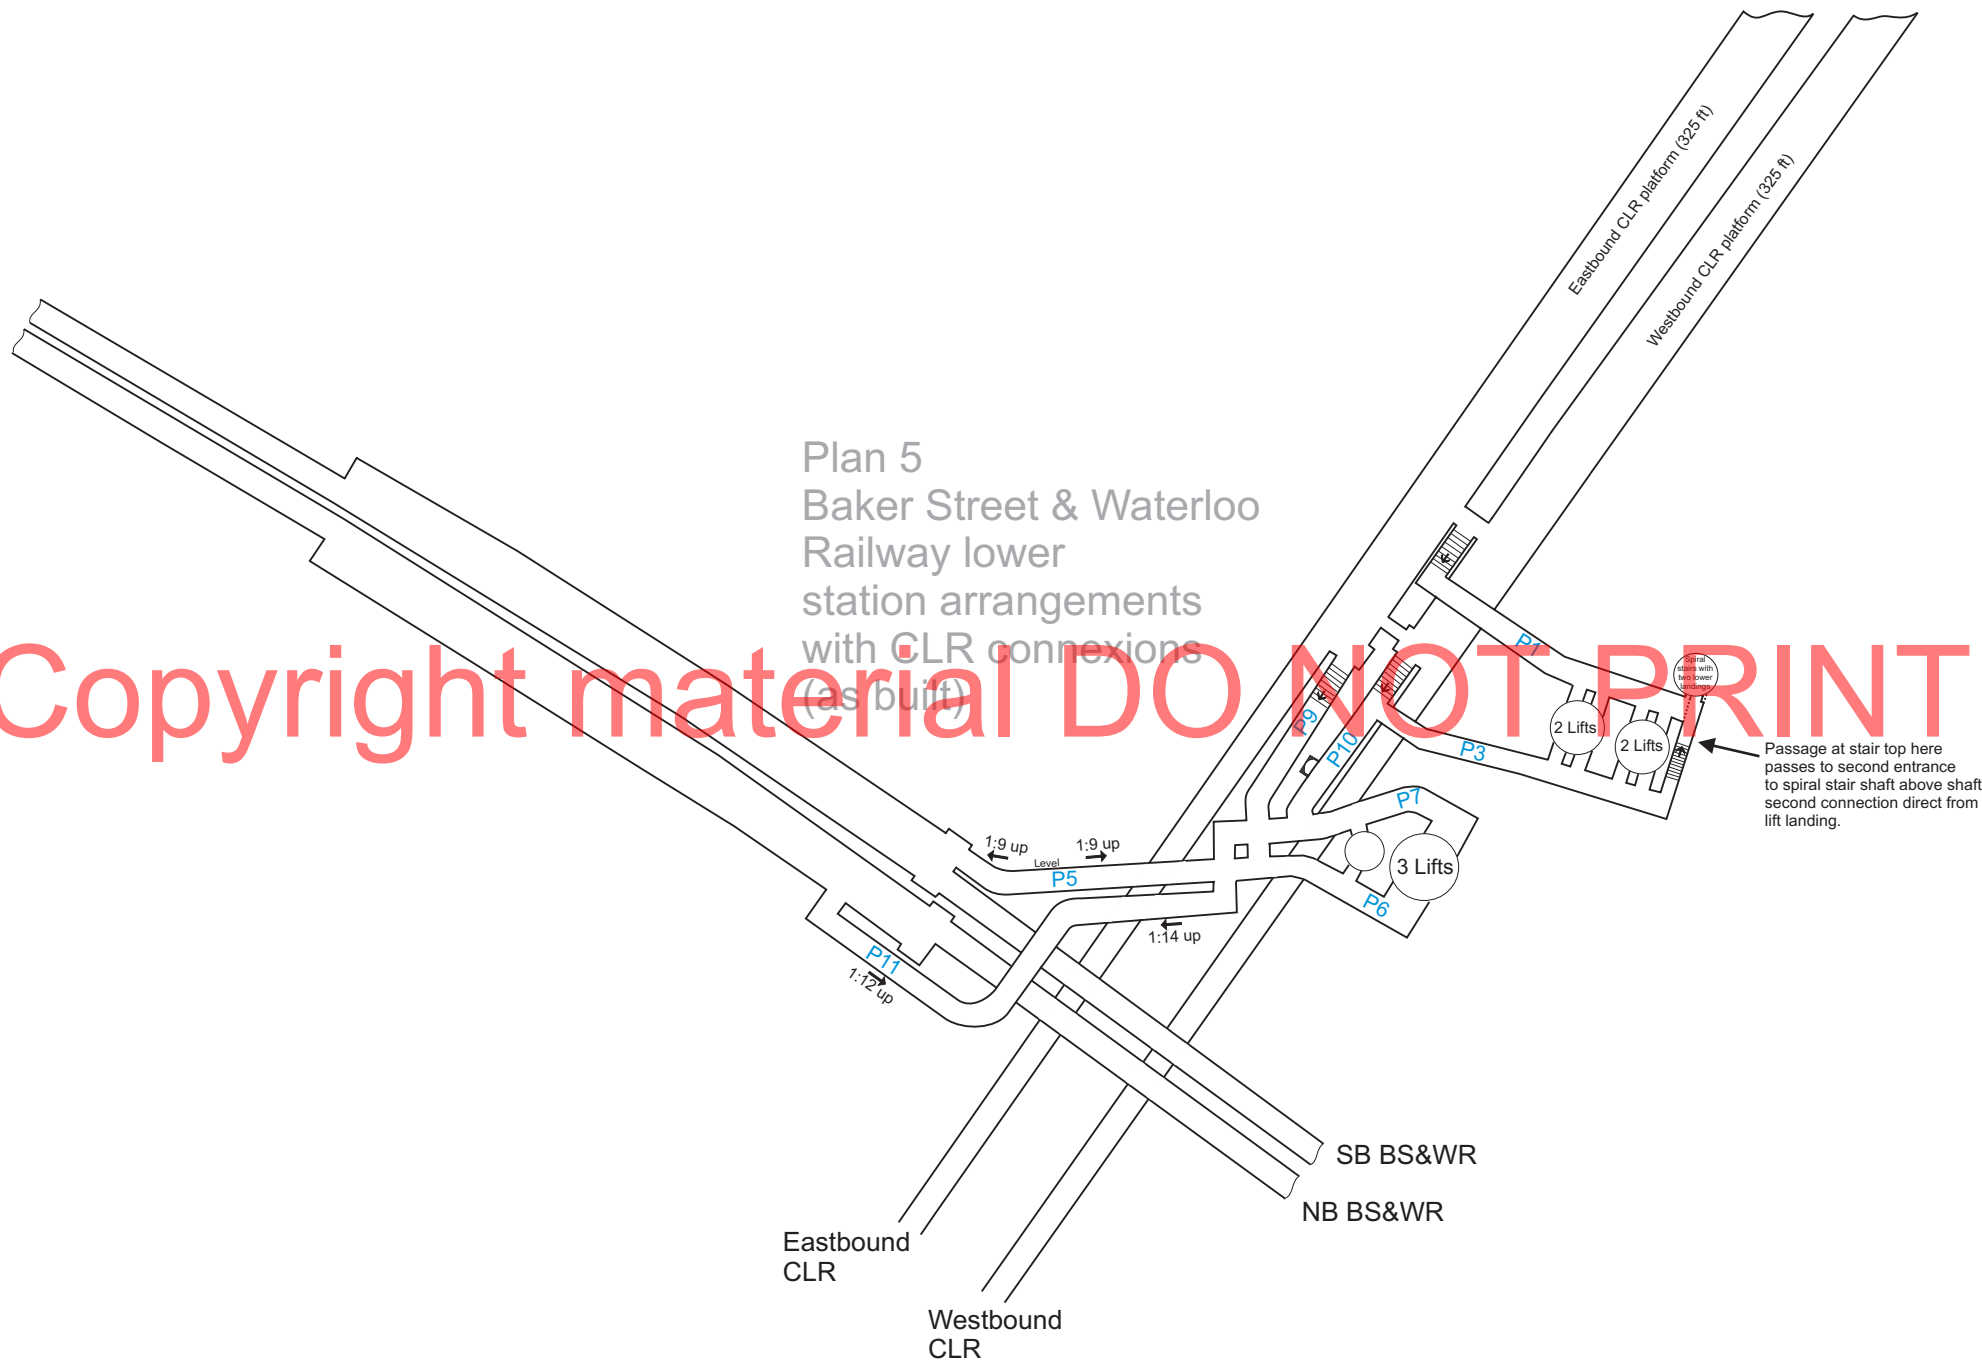

Plan 6
Showing addition of
two Bakerloo escalators
1914

Copyright material DO NOT PRINT

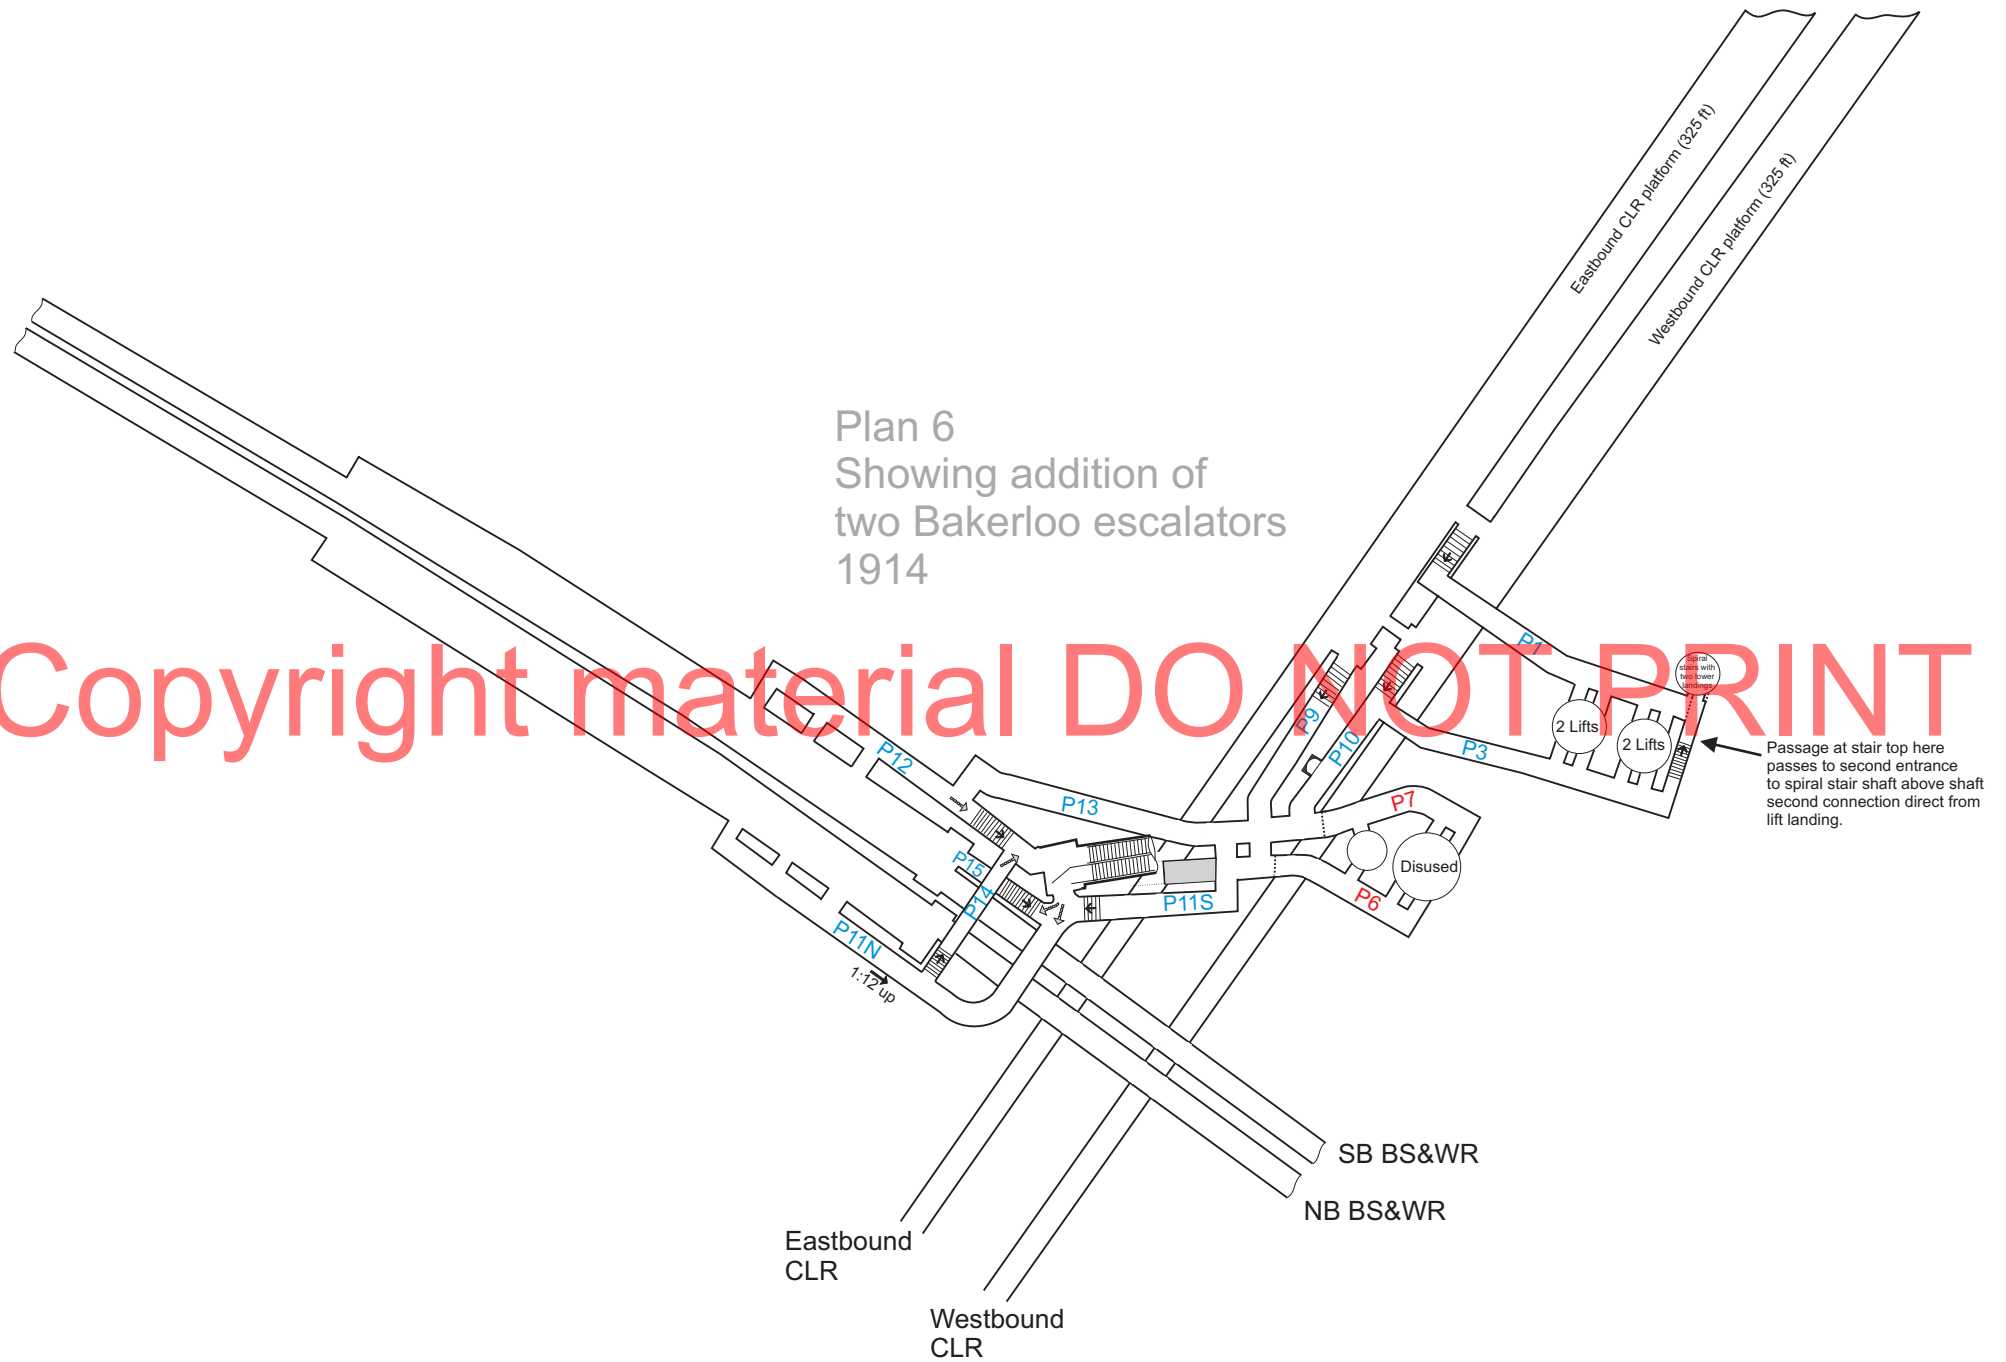

Plan 7
Showing addition of
third Bakerloo escalator
and new low level
passages 1926

Copyright material DO NOT PRINT

